



The property occupier / owner  
Brookmead Way  
Havant, Hampshire

BY HAND

<i>Enquiries to</i>	Civil Engineering Team	<i>My reference</i>	SM/21072017/1
<i>Direct Line</i>	023 9244 6444	<i>Your reference</i>	
<i>Date</i>	21 July 2017	<i>Email</i>	<a href="mailto:steve.mountain@havant.gov.uk">steve.mountain@havant.gov.uk</a>

Dear Sir / Madam

## **Langstone Road Cycling and Pedestrian Infrastructure**

I write further to my letter dated 21 February advising you of the intention of carrying out road works in Langstone Road to create a new cycle track along the west side of the highway.

This is part of an ongoing programme of works by Hampshire County Council, as highway authority, to create a viable and logical cycle network across the Havant area. Havant Borough Council is acting as the County Council's design and implementation consultant. In that earlier letter we invited comments and feedback and could I thank everyone who responded to that letter with observations and concerns, and I trust that the responses we provided in the meantime, including the FAQ document, have alleviated your concerns.

We are proposing to carry out the work in a number of phases as funding allows. The first phase of works will see the west footway between Langbrook Close and the entrance to Langstone Technology Park widened to allow for its future use as a cycle route. However at this stage, since it will not connect to anything, its status will not be changed.

This first phase of work will start on Tuesday 1 August 2017 and run for a period of approximately 6 weeks. During this time a new kerb line will be installed with raised bus access kerbs serving the upgraded bus stop which will include provision of a shelter. The crossing island will be upgraded to modern standards with new tactile paving installed at crossing points to assist people with poor or no vision.

In my original letter we expected the work to be carried out at night. Most of the work is now planned to be undertaken during the day, under restricted hours arrangements, starting at 0930 and finishing at 1600. We will review the impact this has on traffic but since at this point the road is widening to two lanes no impact is expected. However there will be a need for limited night working on a few days during the 6 weeks, to undertake planing to establish the new kerb line, and to remove /

install new white and yellow lining. Night working is defined as any working after 2000 and we expect to not require working beyond 2300.

The scheme includes provision of a 'yellow box' junction at the entrance to Langstone Technology Park, and stronger lining for the right turn (southbound) into Langbrook Close. You will have seen the 'merge' signs for southbound traffic we have already erected at the Woodbury Avenue junction.

All the details are shown on the plan attached.

We will be establishing a small working compound on the public highway outside numbers 4 and 6 Langbrook Close. This will contain a container for equipment, a small welfare unit for the use of the site workers, and room for storage of materials such as kerbs and channels.

Thank you for your co-operation whilst we carry out these works.

Yours faithfully

A handwritten signature in black ink, appearing to read 'SJM', followed by a long horizontal flourish.


Steve Mountain

Civil Engineering Team Leader  
Engineering and Landscape  
Public Service Plaza  
Civic Centre Road  
Havant PO9 2AX

Enclosures:

Plan of overall scheme (drawing 2016\_27/030)  
Plan of Langstone Technology Park section (drawing 2016\_27/034)  
Plan of Langbrook Close junction (drawing 2016\_27/039)

If you require better quality or larger copies of the drawings these can be provided to your email address, or in hard copy print on application to the above.

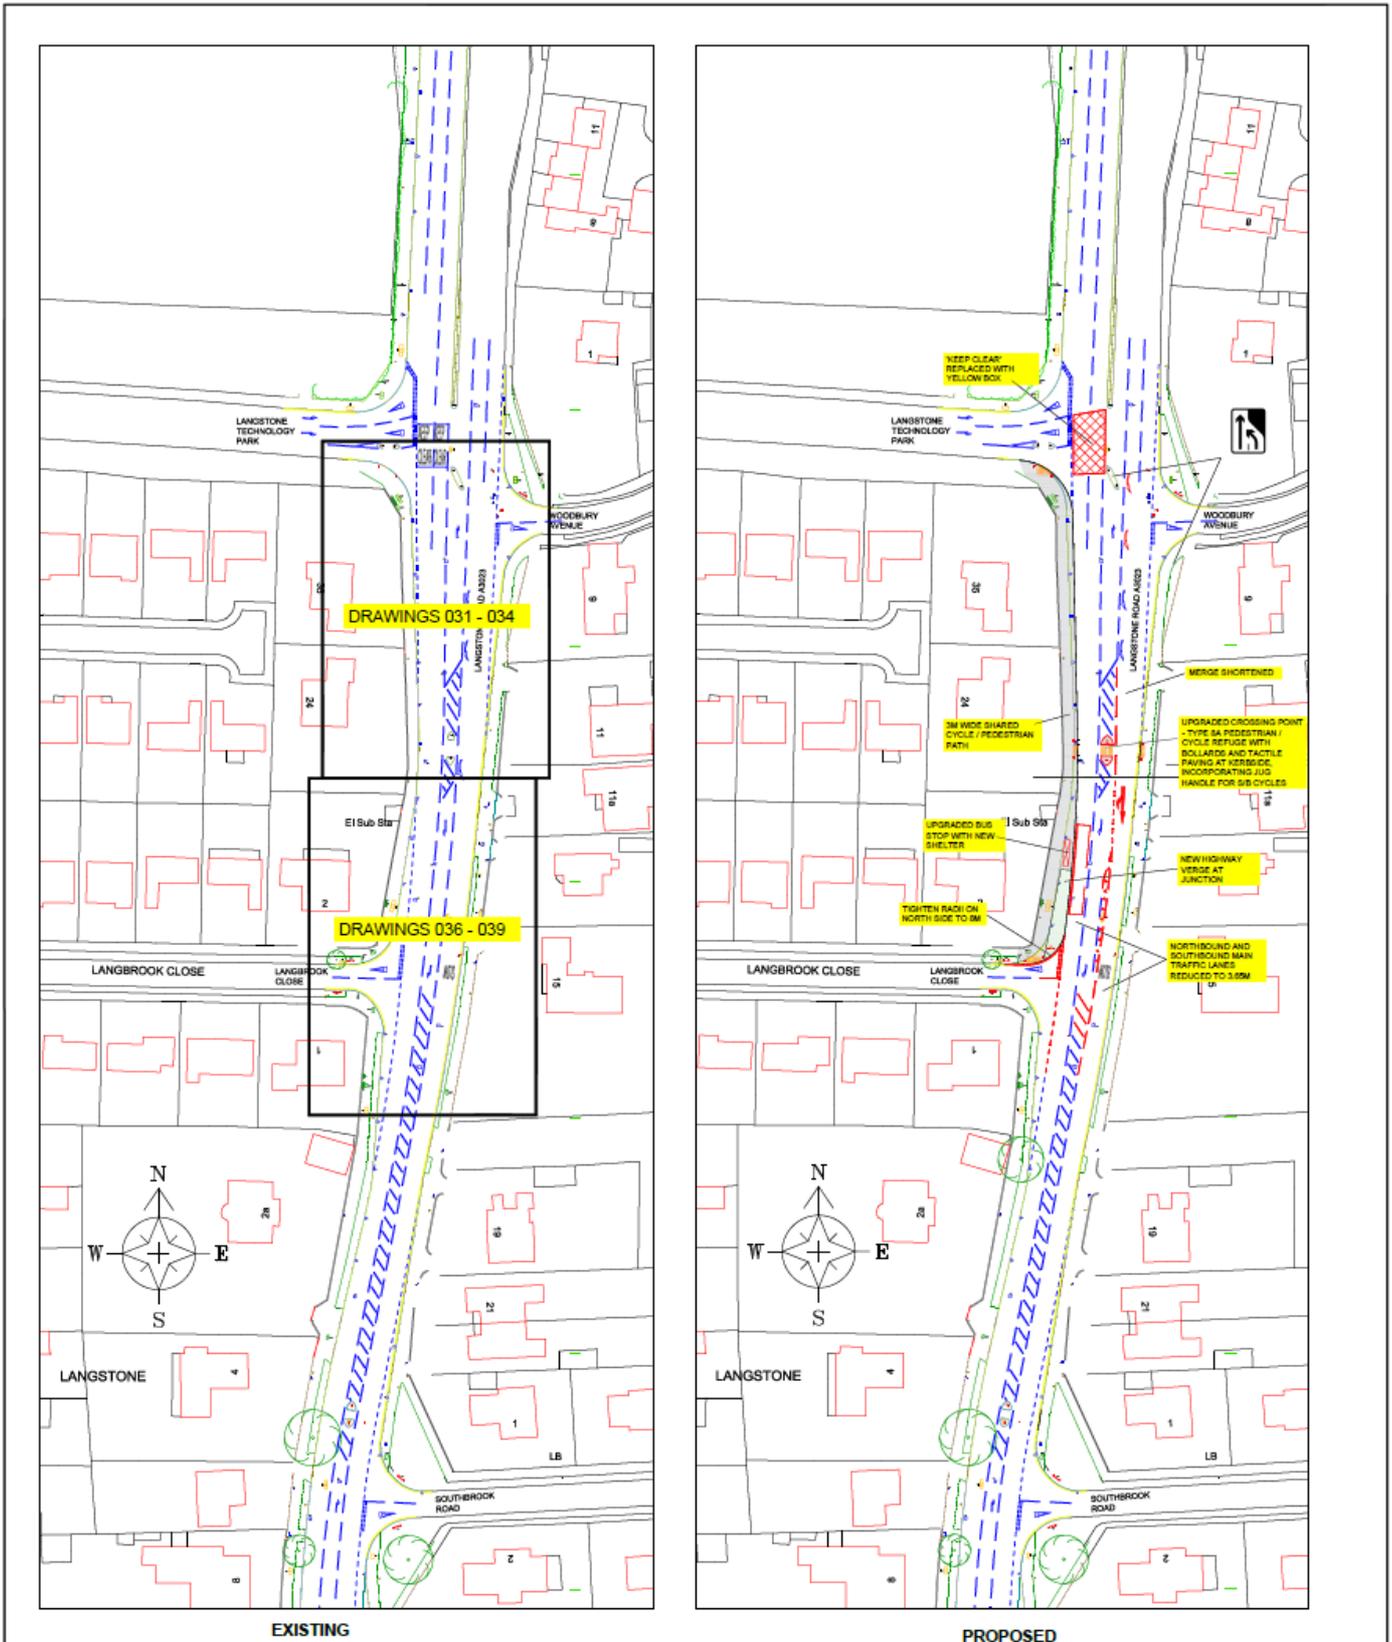

EXISTING

PROPOSED

"REPRODUCED FROM THE ORDINANCE SURVEY MAPS WITH THE PERMISSION OF THE CONTROLLER OF HER MAJESTY'S STATIONERY OFFICE. CROWN COPYRIGHT © UNAUTHORISED REPRODUCTION INFRINGES CROWN COPYRIGHT AND MAY LEAD TO PROSECUTION OR CIVIL PROCEEDINGS." "HAMPSHIRE COUNTY COUNCIL, 2005"

NOTES

1. THIS DRAWING SHOWS THE OVERALL SCHEME LAYOUT. REFER TO OTHER REFERENCED DRAWINGS FOR CONSTRUCTION DETAILS
2. THIS DRAWING SHOWS ALL SURFACE ELEMENTS OF THE PROPOSED SCHEME EXCLUDING DRAINAGE AND STREET FURNITURE
3. DO NOT SCALE FROM THIS DRAWING
4. ALL DIMENSIONS IN MM UNLESS OTHERWISE STATED
5. BLUE ROAD LINING = EXISTING, RED ROAD LINING = PROPOSED

REV	DESCRIPTION	DATE	CAO	CHKD	APPD

**Hampshire County Council**

PLANNING

STUART JAMES (S15) 01753 743117, SECTION OF ECONOMIC, TRANSPORT & ENVIRONMENT, THE CATTLE MARKET, SOUTHAMPTON


**Havant Borough Council**

Public Service Plaza  
Civic Centre Road  
Havant, Hants, PO9 2AX  
Telephone: (023) 5247 4174  
Email: customer.services@havant.gov.uk  
Internet: www.havant.gov.uk

DESIGN	SM	SCALE	1:500
DATE	SM	DATE	6 APR 17
CHECKED	SM	SHEET NUMBER	1 of 1
APPROVED	SM	DRAWING NUMBER	2016_27/030


**KEY LAYOUT DRAWING (EXISTING AND PROPOSED)**

2016\_27/030

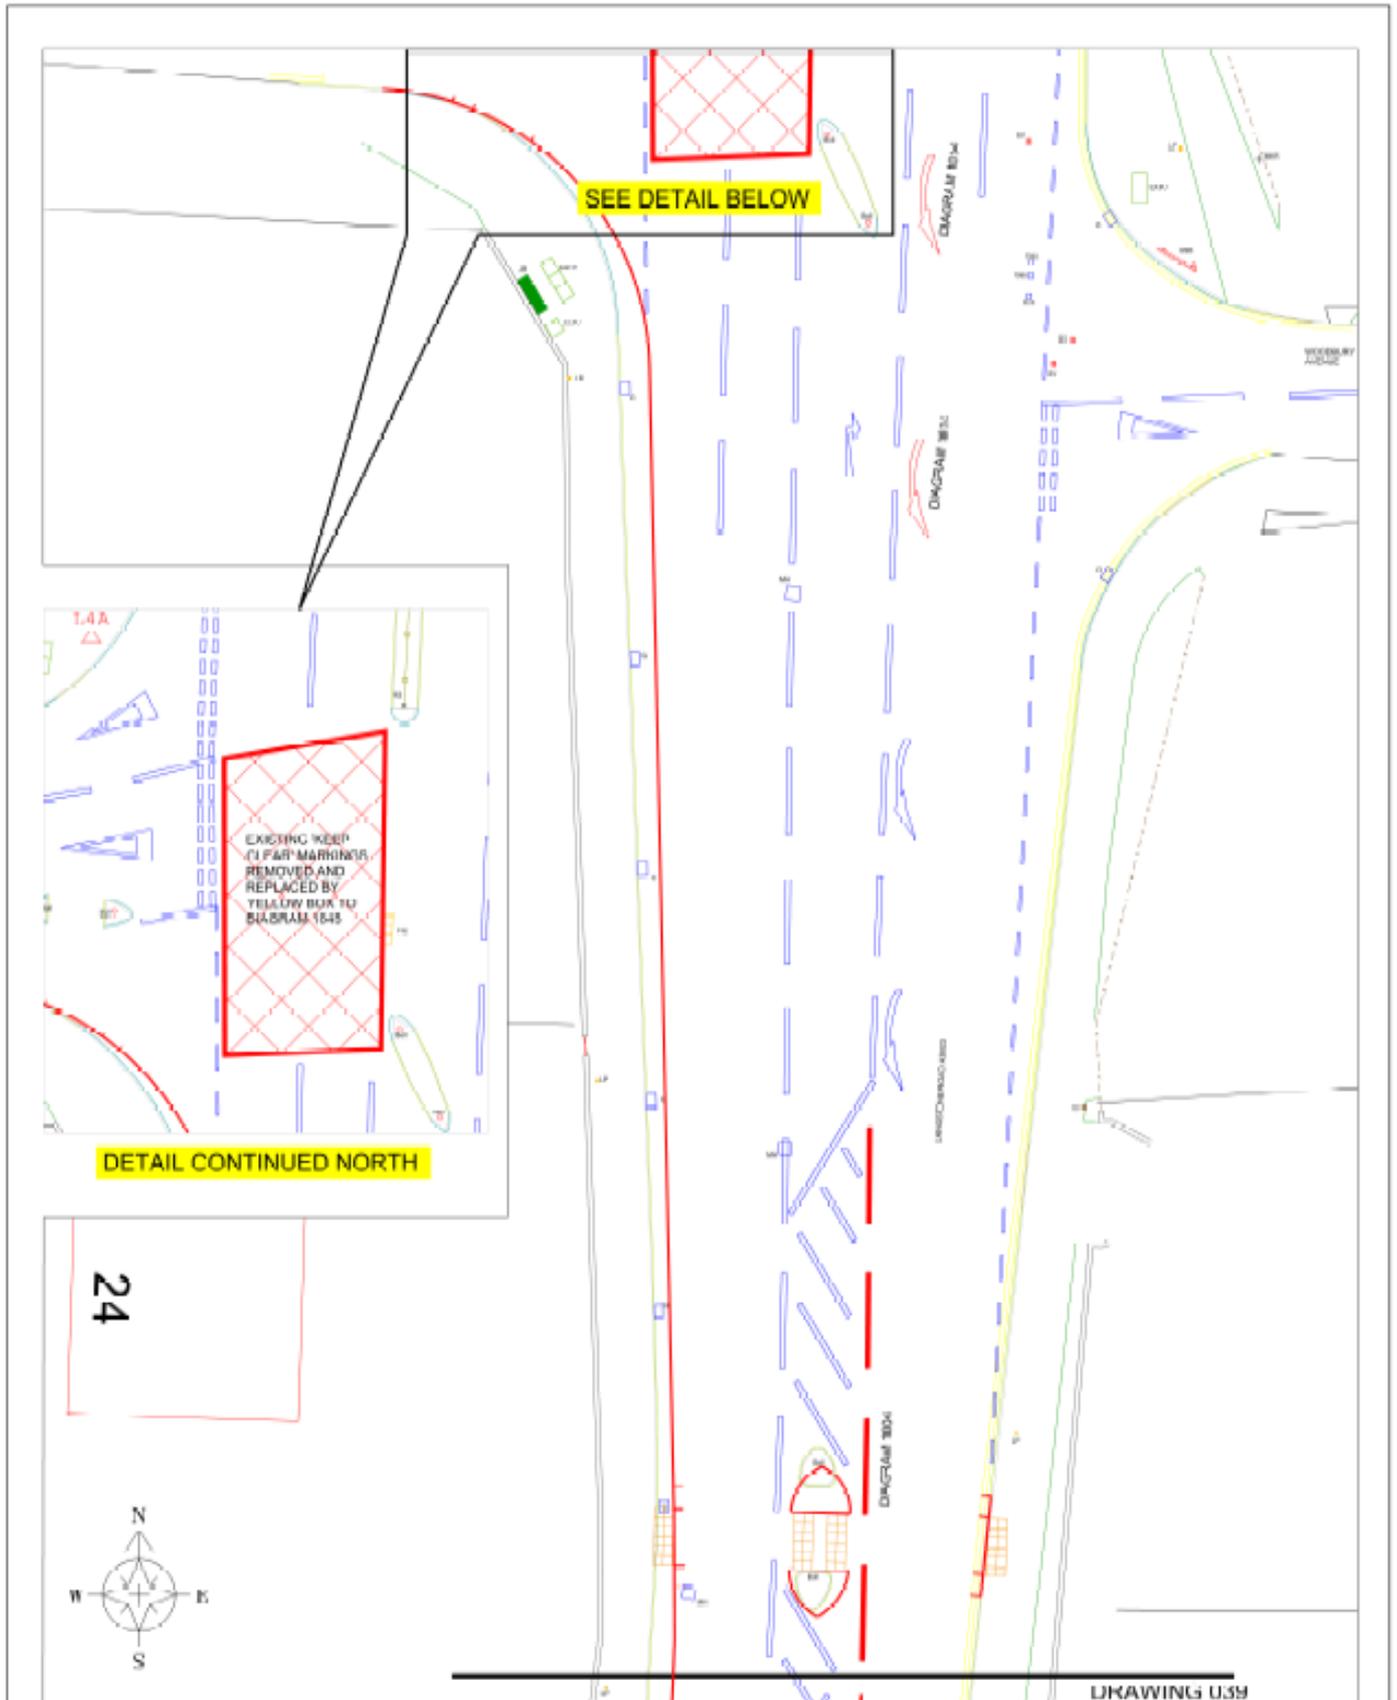

DETAIL CONTINUED NORTH

24

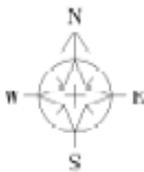

REPRODUCED FROM THE ORIGINAL SURVEY MAPPING WITH THE PERMISSION OF THE ARCHITECTS. ALL RIGHTS RESERVED. THIS DOCUMENT IS THE PROPERTY OF THE ARCHITECTS AND IS NOT TO BE REPRODUCED OR COPIED IN ANY MANNER WITHOUT THE WRITTEN PERMISSION OF THE ARCHITECTS.

PROPOSED ROAD LINING SHOWN IN RED  
EXISTING ROAD MARKINGS TO REMAIN SHOWN IN BLUE

NUMBERS REFER TO FORMS

ALL ROAD MARKINGS TO BE WHITE THERMOPLASTIC UNLESS OTHERWISE STATED

NO.	DESCRIPTION	DATE	BY	CHECKED	SCALE


**Hampshire County Council**  
 Planning and Transport Services  
 Planning Department

**Havant Borough Council**  
 Planning Department

Public Access Point  
 10000 10000 10000  
 10000 10000 10000  
 10000 10000 10000  
 10000 10000 10000

NO.	DESCRIPTION	DATE	BY	CHECKED	SCALE

**Hamstone Technology Park Access Road Lining**  
 DATE: 0 APR 17  
 SCALE: 1:100  
 SHEET: 1 of 1  
 PROJECT: 2016\_27/034

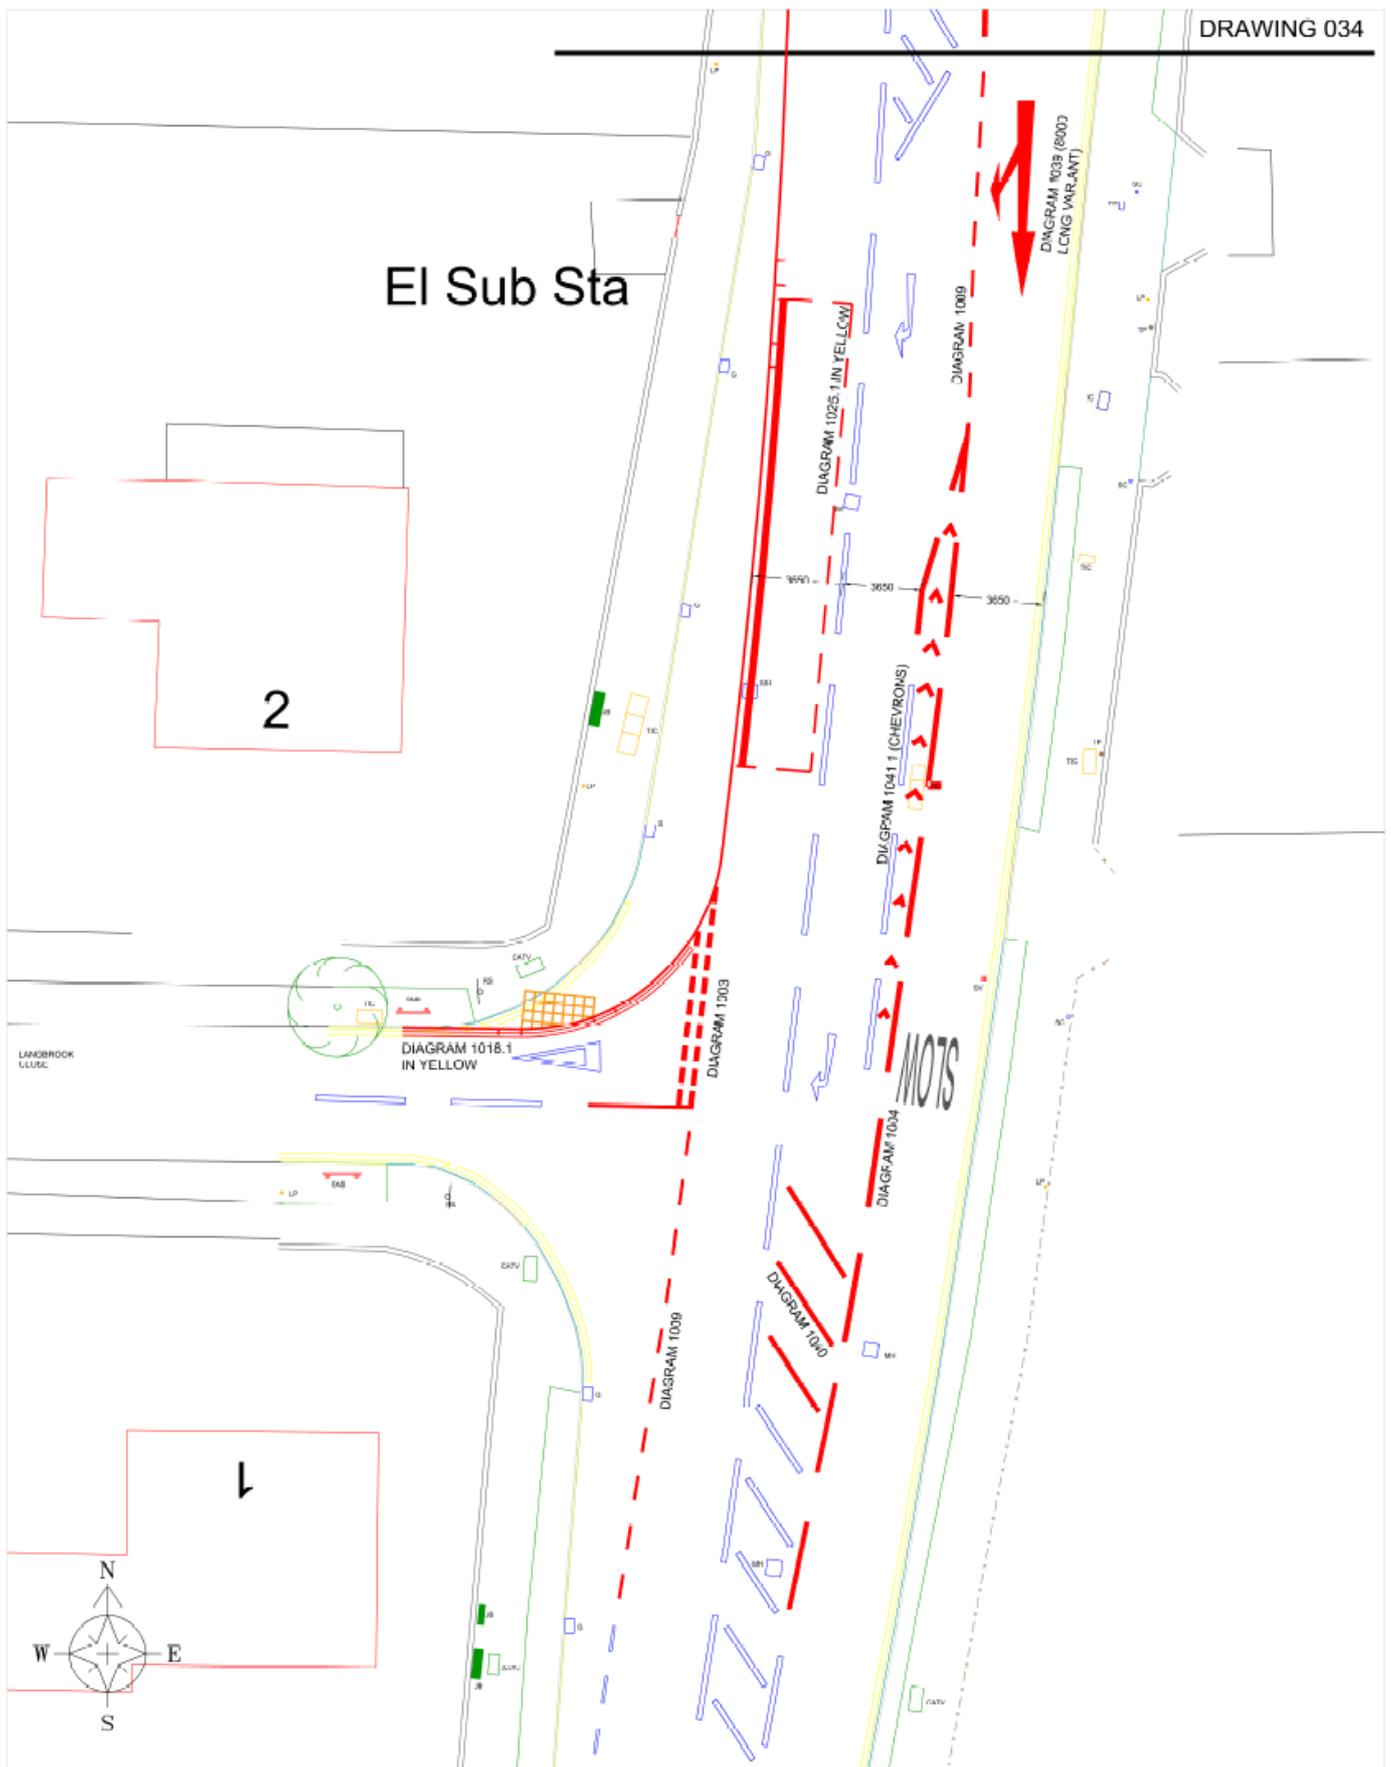

REPRODUCED FROM THE ORDINANCE SURVEY MAPS WITH THE PERMISSION OF THE CONTROLLER OF HER MAJESTY'S STATIONERY OFFICE. CROWN COPYRIGHT © UNAUTHORISED REPRODUCTION INFRINGES CROWN COPYRIGHT AND MAY LEAD TO PROSECUTION OR CIVIL PROCEEDINGS. "HAMPSHIRE COUNTY COUNCIL, 07665"

PROPOSED ROAD LINING SHOWN IN RED  
EXISTING ROAD MARKINGS TO REMAIN SHOWN IN BLUE

DIAGRAM NUMBERS REFER TO TSRGD

ALL ROAD MARKINGS TO BE WHITE THERMOPLASTIC UNLESS OTHERWISE STATED

REV	DESCRIPTION	DATE	BY	CHECKED	APPROVED

**Hampshire County Council**  
 PLANNING  
 1000 High Street, Winchester, Hampshire, SO14 2DQ  
 Tel: 01962 843400  
 Fax: 01962 843401  
 Email: [planning@hampshire.gov.uk](mailto:planning@hampshire.gov.uk)

**Havant Borough Council**  
 Planning  
 1000 High Street, Havant, Hampshire, PO9 2AX  
 Tel: 023 9247 4174  
 Fax: 023 9247 4175  
 Email: [customer.services@havant.gov.uk](mailto:customer.services@havant.gov.uk)

Public Service Plaza  
 Civic Centre Road  
 Havant, Hants, PO9 2AX  
 Telephone: (023) 9247 4174  
 Email: [customer.services@havant.gov.uk](mailto:customer.services@havant.gov.uk)  
 Internet: [www.havant.gov.uk](http://www.havant.gov.uk)

DESIGNED	SM	SUBMIT	
CHECKED	CM		
DATE			

LANGSTONE ROAD / LANGBROOK CLOSE

DRAWING TITLE	LANGBROOK CLOSE ROAD LINING
DATE	6 APR 17
SCALE	1:100
SHEET NUMBER	1 of 1
DRAWING NUMBER	2016_27/039